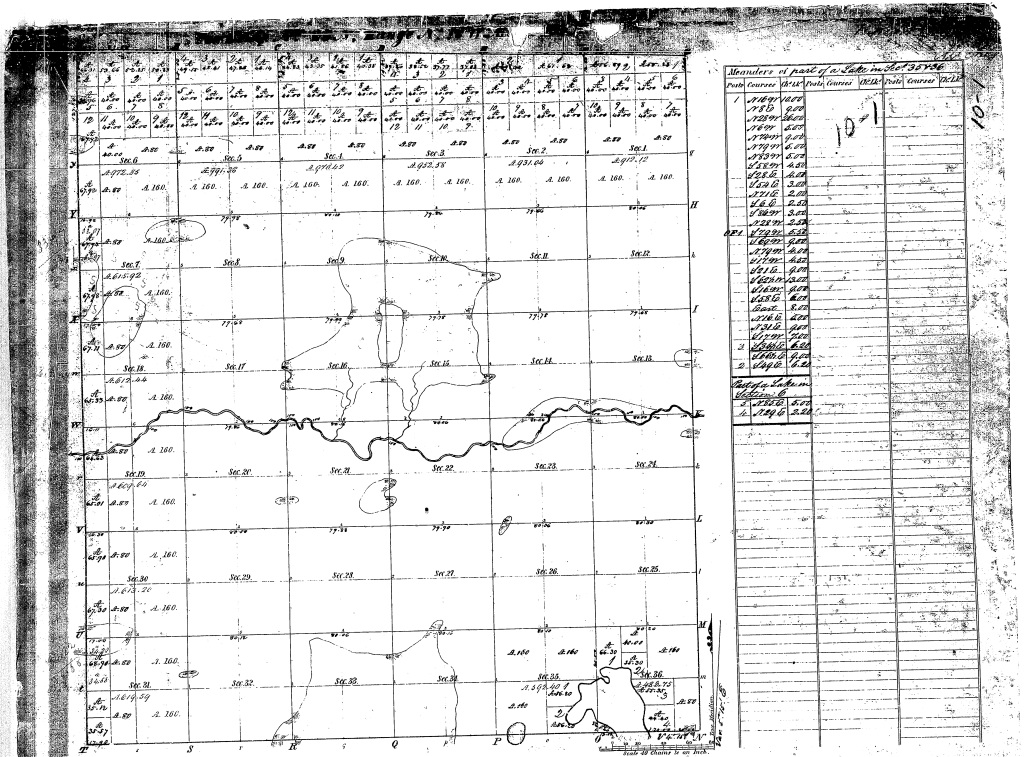


Poles	Courses	Dist.	Poles	Courses	Dist.
1	N 60° W	10.50			
	N 75° W	8.00			
	N 29° W	24.00			
	N 60° W	8.00			
	N 39° W	4.00			
	N 77° W	6.00			
	N 39° W	8.00			
	S 51° W	4.00			
	S 28° E	4.00			
	S 55° E	3.00			
	S 72° E	2.00			
	S 48° E	2.50			
	S 80° E	3.00			
	S 28° E	2.50			
	S 12° E	6.50			
	S 60° E	6.00			
	S 74° E	8.00			
	S 47° E	8.00			
	S 21° E	9.00			
	S 60° E	10.00			
	S 40° E	9.00			
	S 65° E	8.00			
	East	8.00			
	N 74° E	8.00			
	N 39° E	9.00			
	N 77° E	7.00			
2	N 60° E	6.50			
2	N 60° E	9.00			
2	N 49° E	6.50			

Part of Lake in Meanders

1.	114	5.00
2.	114	2.50

Total number of Acres 24,600.33

Surveys Designated	By Whom Surveyed	Date of Contract	Amount of Surveys	When Surveyed	When plats and field notes were filed in the Surveyor General's office
Township lines	Austin E. Wing	Nov. 17th 1837	96 Miles 59 chs. 50 lks.	9th of Sept. 1838	5th of Feb. 1839
Subdivisions	John Farmer	Feb. 16th 1839	624 " 51 " 92	31st of Aug. 1839	4th of Sept. 1839
N. Boundary	James Clarke	Nov. 4th 1836	5 " 76 " 98	6th of Feb. 1837	5th of Feb. 1838


Surveyor Generals Office
Detroit July 15th 1839

C. S. Rodney Surv. Genl.