Township N° 14 N., Range N° 7 West Mer: (Mich.)

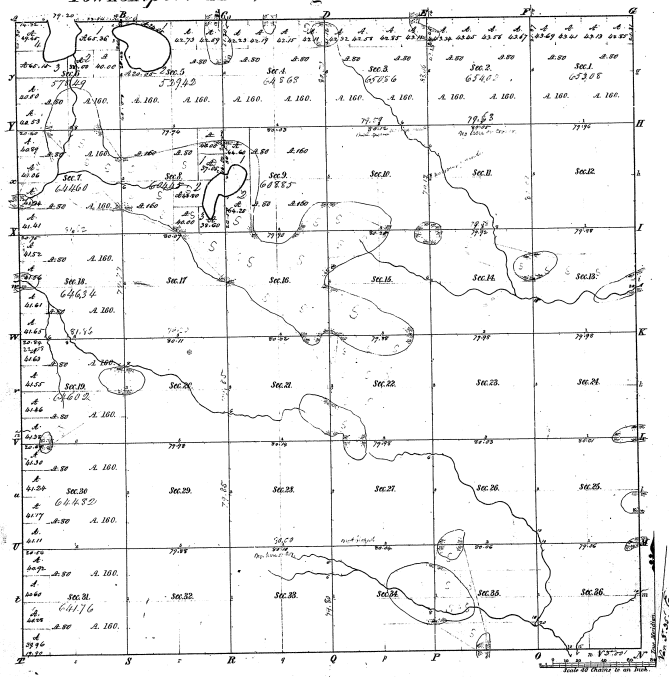

Meanders of Locks.	
Prods Courses	Prods Courses
Locks in Sect 5 & 6	
1	77.0 E. 23.50
	72.0 S. 14.00
	73.0 W. 11.00
	West 8.00
	62.0 W. 9.50
2	77.0 W. 22.50
	77.0 W. 3.00
	63.0 W. 19.50
	52.0 W. 14.50
	48.0 E. 12.00
	East 3.00
	47.0 E. 13.50
1	72.0 E. 7.00
Locks in Sect 7 & 8	
9	43.0 W. 6.00
	21.0 W. 6.00
4	47.0 E. 8.62
	72.0 E. 13.00
	48.0 E. 23.50
	39.0 E. 11.00
	19.0 E. 8.50
	43.0 W. 11.00
	47.0 W. 13.50
	22.0 W. 2.50
	43.0 W. 12.00
	21.0 W. 14.00
	12.0 E. 7.00
3	12.0 W. 2.10
Part of the Shore in Section 6	
5	43.0 E. 8.00
	62.0 E. 7.00
	South 9.50
	56.0 W. 12.50
	43.0 W. 8.00
	19.0 W. 7.50
	12.0 E. 12.50
6	12.0 W. 2.10

Total number of Acres 22,871.39

Surveys Designated	By Whom Surveyed	Date of Contract	Amount of Surveys	When Surveyed	When accepted and filed in the Surveyor Genl's office
Township lines	John Mullett	April 12, 1837	M. Ch. Lks. 24 80 51	1837	1838
subdivisions	J. Mullett	July 24, 1838	24 44 72	1839	1839

The above Map of Township N° 14 North of Range N° 7 West of the Principal Meridian Michigan is strictly conformable to the field-notes of the surveys thereof on file in this Office, which have been examined and approved.

Surveyor Generals Office
Cincinnati, July 4, 1839

E. S. Thomas
Surv. Genl

12-26

12-26