Islands in Muskegon River

Township No. 15 N. Range No. 10 W. Mer. Mich.

11-22

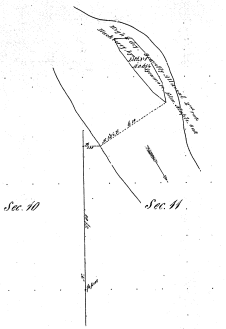

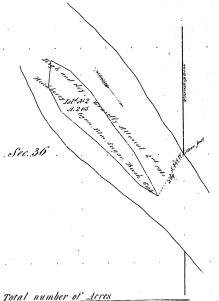

Meanders of								
Posts	Courses	Ch.s Lk.s	Posts	Courses	Ch.s Lk.s	Posts	Courses	Ch.s Lk.s

Scale 4 Chains to an Inch.

Total number of Acres.

Surveys Designated.	By Whom Surveyed.	Date of Contract.	Amount of Surveys M. Ch.s Lk.s	When Surveyed.	When Changed to the Surv.r Genl's Acc.t
Township lines.					
Subdivisions.	The Whelpley	Instructions May 1st 1854		1856	

The above Map of Township No. 15 North of Range No. 10 West of the Principal Meridian, of Michigan is strictly conformable to the field notes of the survey thereof on file in this Office, which have been examined and approved.

Surveyor General's Office, Detroit April 15th 1857 } C. L. Emerson Sur.r Genl.

11-22 (2)