Resurvey

# Township No. 29 N. Range No. 3 W. Mer. Mich.

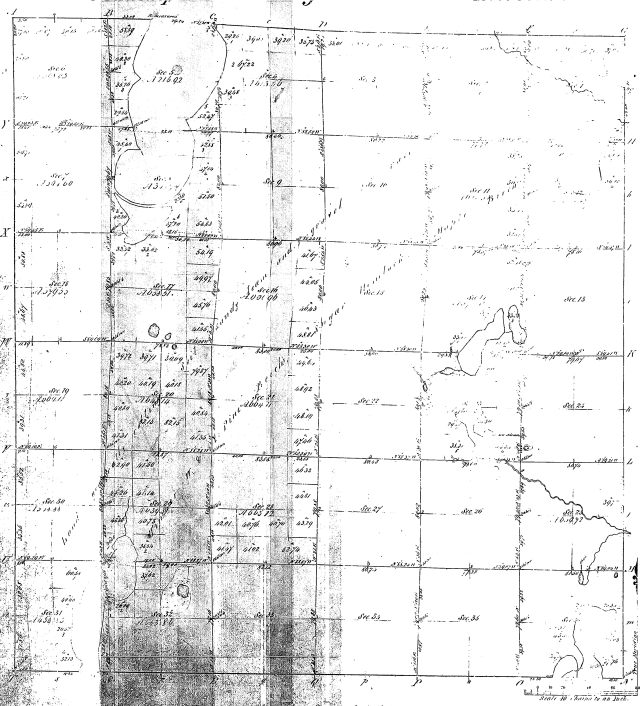


Total number of Acres 21,406.11

| Sections Corrected. | Height of Section | Length of Section | Width of Section | Width Changed in the Sur. Gen. Ave. |
|---|---|---|---|---|
| Sections | | | | |

The above Map of Township No. 29 North of Range No. 3 West of the Principal Meridian of Michigan is strictly conformable to the field notes of the survey thereof on file in this Office which have been examined and approved.

Surveyor General's Office
St. Paul's Aug. 24th 1857

[illegible] Sur. Genl.

14-7