Township N° 21 N. Range N° 2 W. Mer. Mich

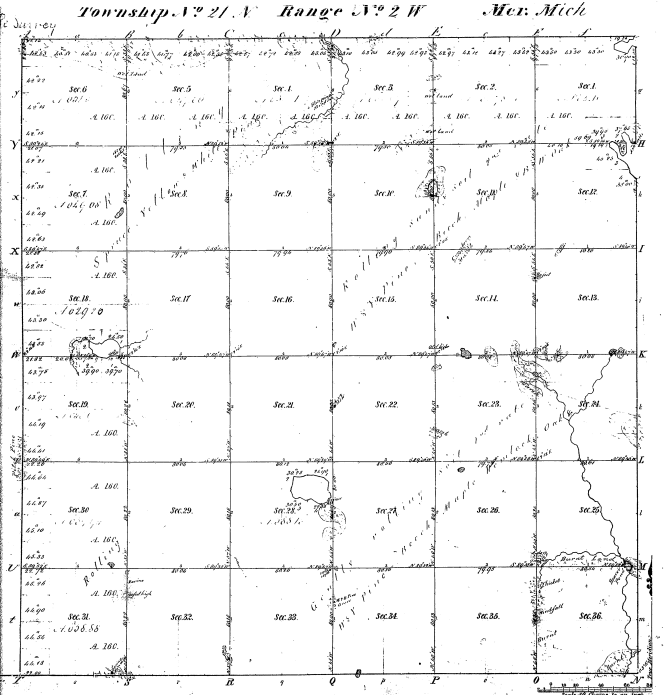

Meanders of
Prairie Courses | Acres | Prairie Courses | Acres | Swamp | Courses | Acres

14-38

Total number of Acres 23103.27

Surveys Designated	By Whom Surveyed	Date of Contract	Amount of Surveys	When Surveyed	Whether Accepted and when by the Surveyor General
Township Lines	John Reid Jr.	Nov 16 1836	96 27 48	1842 Dec 1847	
Subdivisions	W. A. Fitch	Deed Nov 16 1836	65 02 71	3rd Quarter 1850	

The above Map of Township N° 21 N. of Range N° 2 West of the Principal Meridian Michigan is strictly conformable to the field notes of the Surveys of the same which have been approved and accepted

Wash D.C.