Re Survey

Township No. 24 N. Range No. 3 W Mer. Michigan

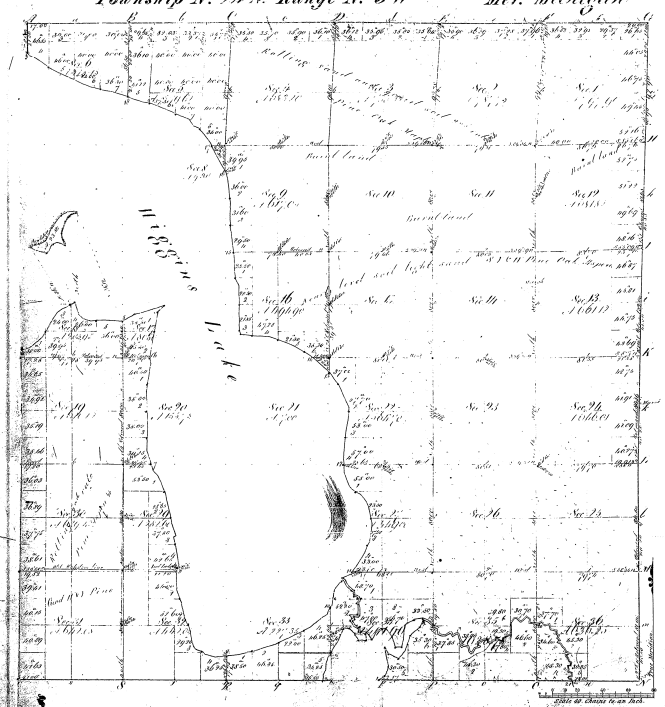

Total number of Acres 17,540.60

Surveys Designated.	By Whom Surveyed.	Date of Contract.	Amount of Surveys M.	Ch.	Lks.	When Surveyed.	When Charged in the Surv. Genl. Ofc.
Township Lines 8th	John Brisch	Nov. 4th 1826	6	0	50	2nd Quar. 1828	
Land boundary R.	Lewis Wm Burk	April 7th 1852	6	18	64	2nd Quar. 1852	
Subdivisions.	William Burk	April 7th 1852	6	60	32	2nd Quar. 1852	
			4	72	72		
			64	23	39		

The above Map of Township No. 24 North of Range No. 3 West of the Principal Meridian Michigan is strictly conformable to the field notes of the survey thereof on file in this Office, which have been examined and approved.

Surveyor General's Office
Detroit Nov 23 1852

Chas. Arthur
Surv. Genl.

Measures of

Units	Courses	Chs. Lks.	Units	Courses	Chs. Lks.	Units	Courses	Chs. Lks.

14-26

16