Resurvey

Township No. 24 N. Range No. 4 W. Mer. Mich.

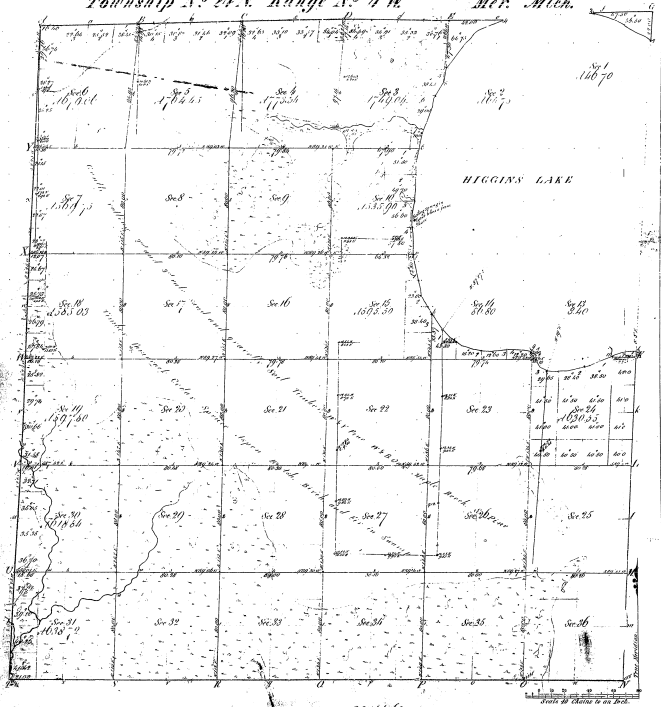

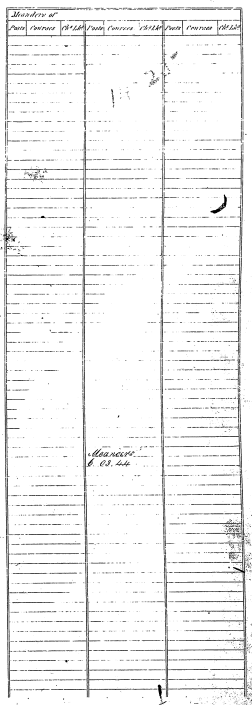

14-25

Total Number of Acres 2074.63

Surveys Designated.	By Whom Surveyed.	Date of Contract.	Amount of Sum Rec'd	When Surveyed.	When Changed to the Surv'r Gen'l's office
Township lines	Edwin Russell	Nov 6 1846	9 24	1st Quar 1849	
Subdivisions	Addison P. Brown	April 20 1849	56 27	2nd Quar 1858	

The above Map of Township No. 24 North of Range No. 4 West of the Principal Meridian, Michigan, is strictly conformable to the field notes of the survey thereof on file in this Office, which have been examined and approved.

Surveyor Genl's Office, Detroit March 24 1859

Chas. Noble Surv'r Genl