Township No. 23 N, Range No. 12 West Mer: (Mich.)

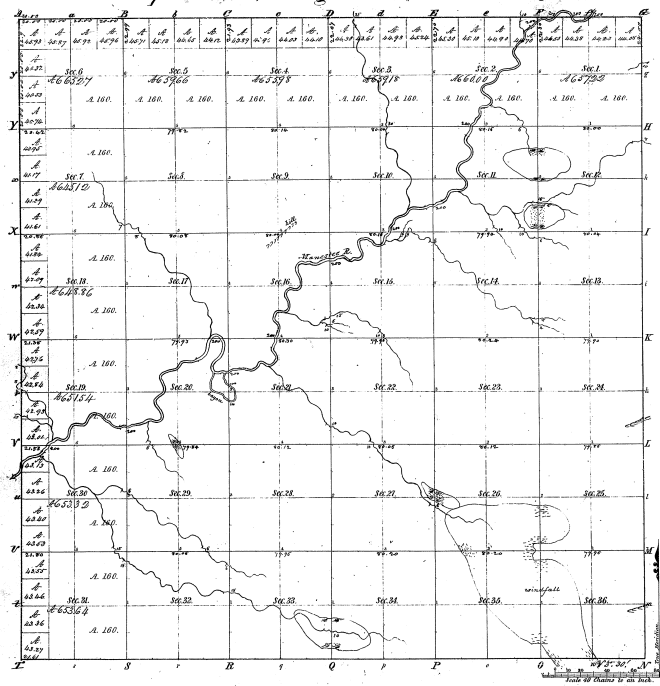

Meanders of					
Poste	Courses	Chs. Lks.	Poste	Courses	Chs. Lks.

16-32

Total number of Acres 23,209.72

Surveys Designated	By Whom Surveyed	Date of Contract	Amount of Surveys	When Surveyed	When returned to the Surr. Genl. Office
Township lines	Johnson & Fowler	Nov. 22d 1836	24 Chs. 45 Lks.	2d qr. 1837	2d qr. 1838
Subdivisions	Same	" " 1839	66 Chs. 40 Lks.	4th qr. 1839	4th qr. 1839

The above Map of Township No. 23 North of Range No. 12 West of the Principal Meridian Michigan is strictly conformable to the field notes of the surveys thereof on file in this office which have been examined and approved.

Surveyor General's Office
Cincinnati, June 8th 1840

C. S. Ewing
Surr. Genl.